

MAP KEY

Shelter Locations

- Primary
- Secondary

REVISION			
01	01-02-14	N/A	UNKNOWN
02	10-21-19	BWW	BUILDING NAME CHANGE ALONG WITH ENTIRE BUILDING RENOVATION



TEXAS WOMAN'S UNIVERSITY

FACILITIES MANAGEMENT & CONSTRUCTION DEPT.

PHYSICAL PLANT SERVICES CENTER DENTON, TEXAS

UPDATED 10-21-19

REVISION # 02

FINE ARTS ANNEX (FAA)


previously known as UNDERGRAD LAB BUILDING (ULB)

FIRST FLOOR PLAN - AS-BUILT

PROJECT NUMBER

SHEET A1

OF 2

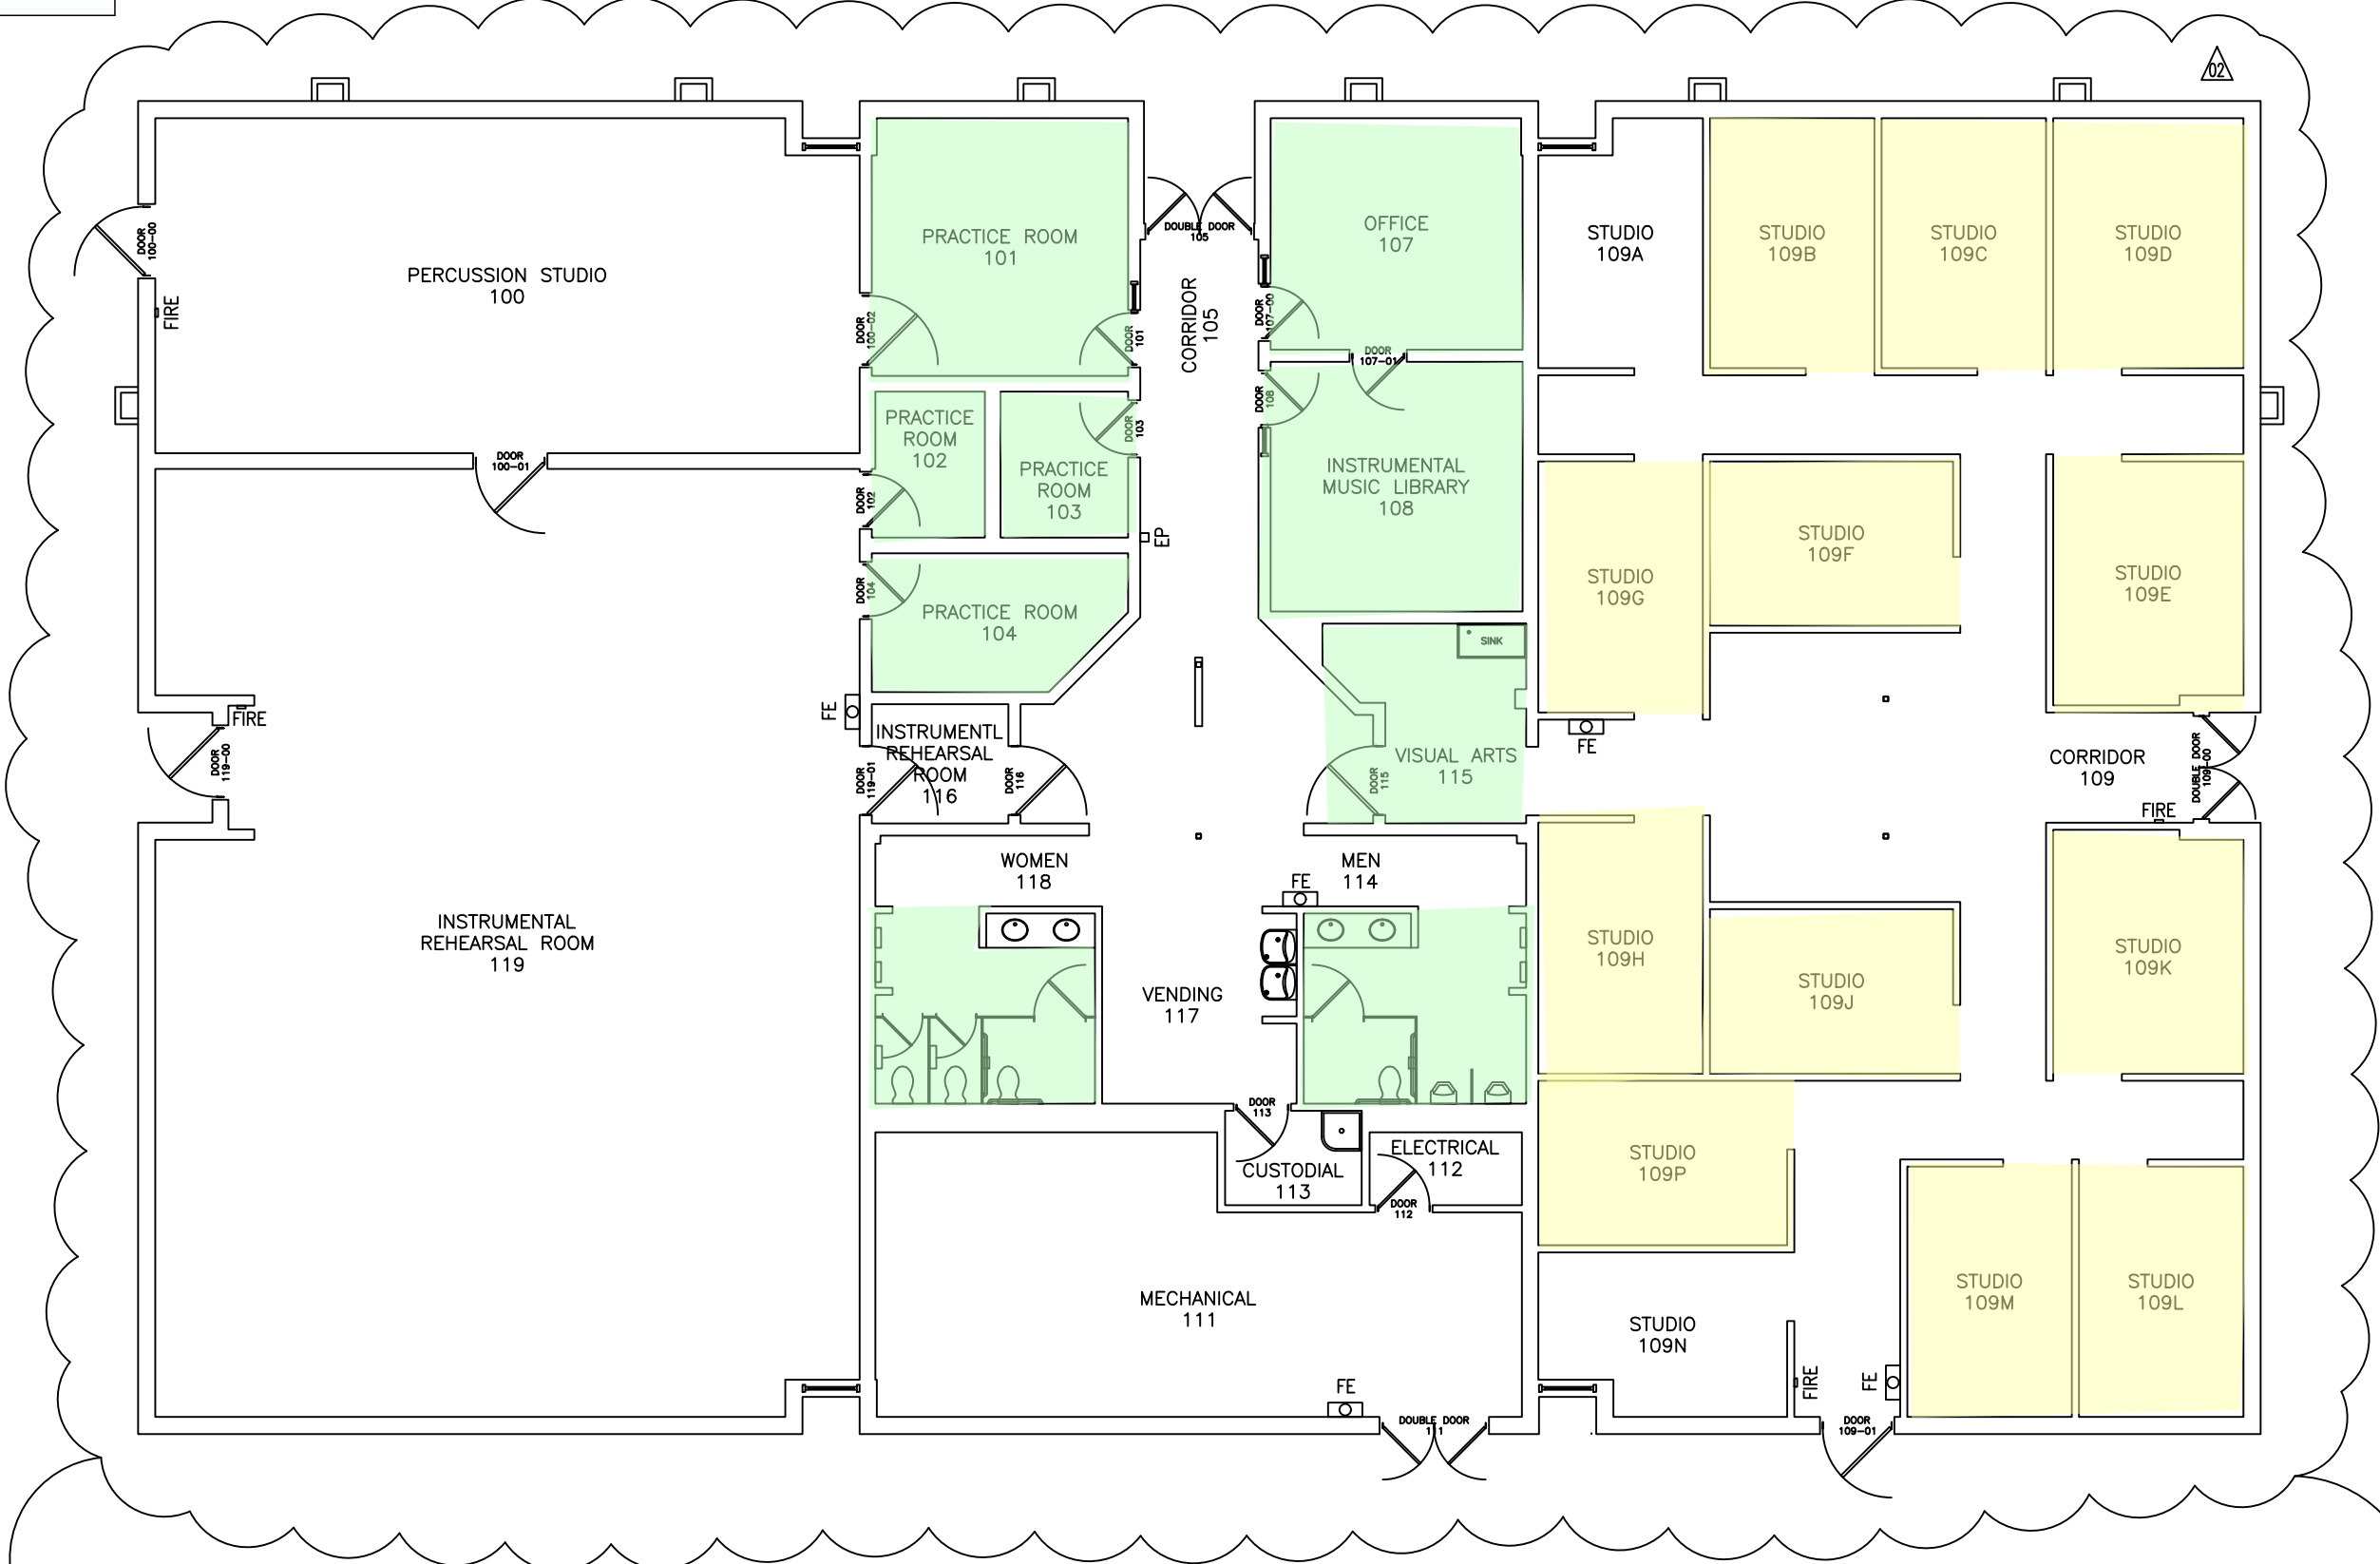

1 FINE ARTS ANNEX (FAA)

1ST FLOOR PLAN

SCALE: 3/32" = 1'-0"



LEGEND

- FIRE PULL
- FIRE EXTINGUISHER
- EMERGENCY PHONE